


Client



Drawing Title

COUNTRYSIDE PROPERTIES
CLAY FARM, CAMBRIDGE
PRIMARY ROUTE SURFACE FINISHES
SCHOOL SQUARE CROSSING

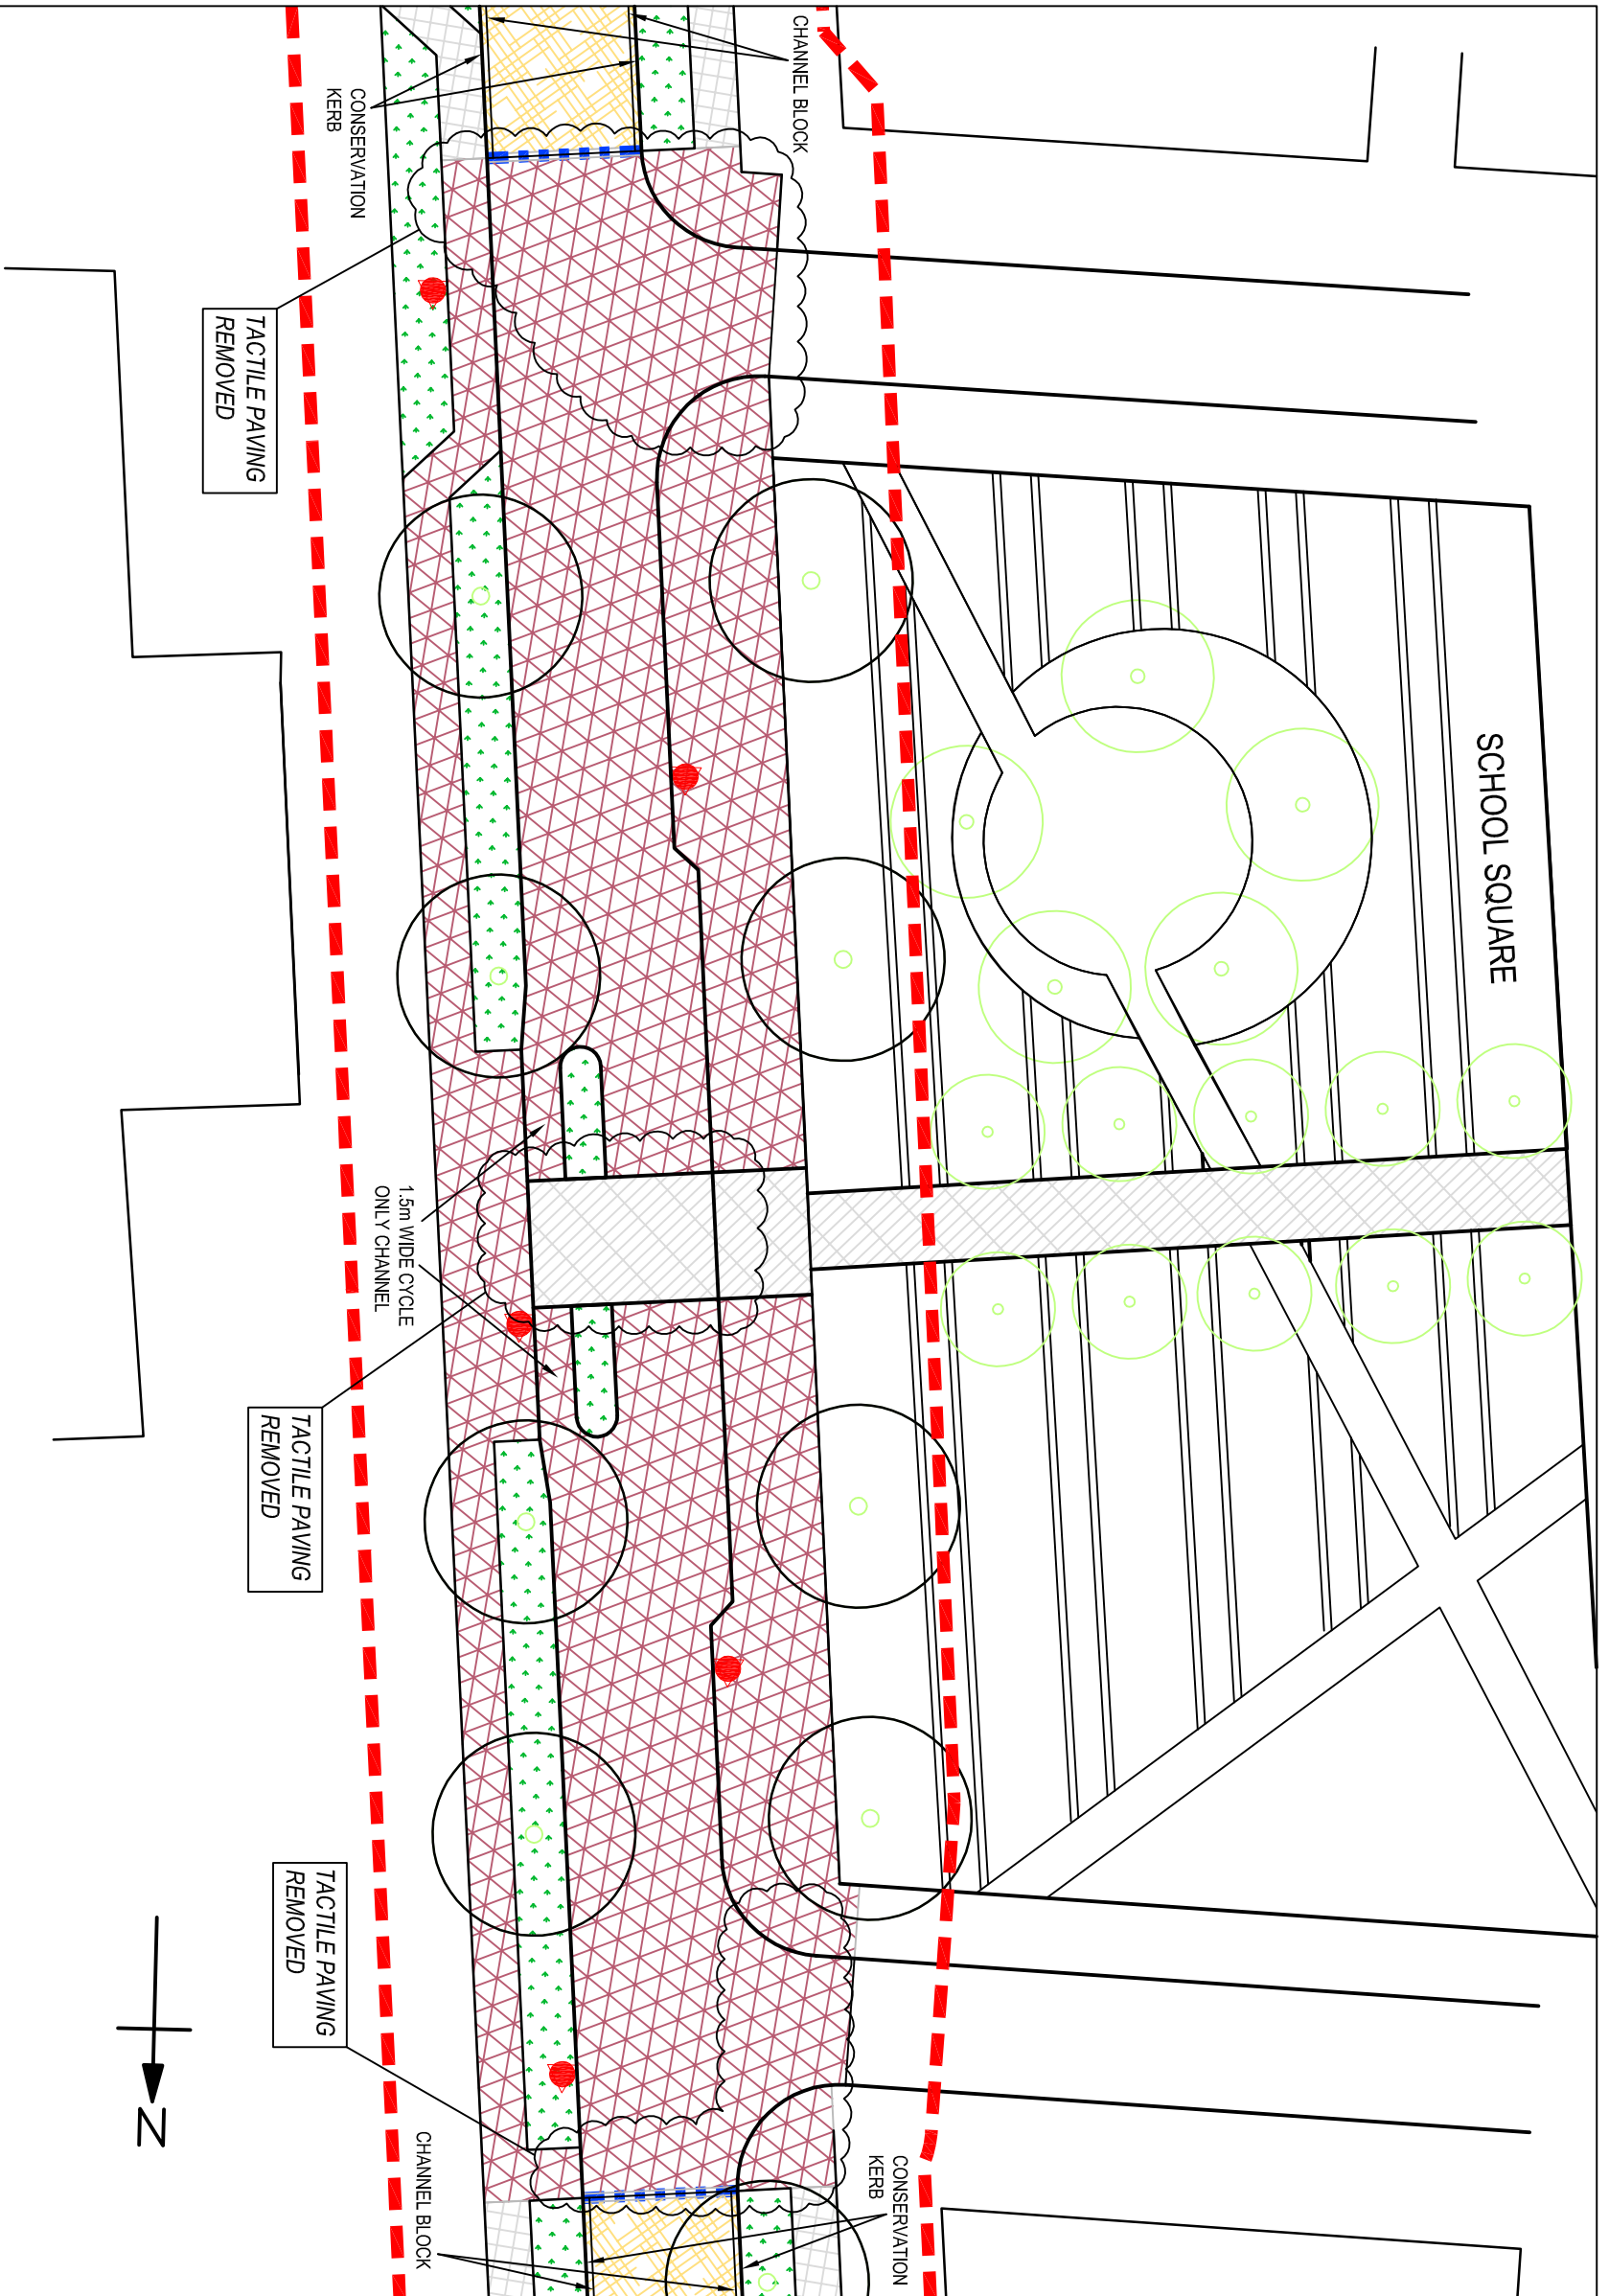

- NOTES:
1. ALL DRAWN INFORMATION OUTSIDE RED LINE IS FOR INDICATIVE PURPOSES ONLY.
 2. FOR JUNCTION LOCATION SEE DRAWING NOS 06_4074 CL_100-CL_102
 3. FOR DIMENSIONS REFER TO DRAWING NOS 06_4074 CL_103-CL_105

KEY

	CARRIAGEWAY / FOOTWAY - KEYBLOCK CHARCOAL
	ANTHRACITE BASALT BLOCK PAVING
	CONTRASTING KEYBLOCK TO MATCH SCHOOL SQUARE SURFACE
	CYCLEWAY-DBM
	CYCLEWAY/FOOTWAY - COLOURED HRA
	FOOTWAY - DBM
	CYCLEWAY/FOOTWAY - COMPACTED GRAVEL
	PLANTING
	CARRIAGEWAY / PARKING AREAS - HRA
	TACTILE SLABS
	75mm RAMP TO RAISED TABLE - GRANITE SETTS
	4 ROWS OF GRANITE SETTS
	STREET LIGHTS
	TRAFFIC LIGHTS
	ROADSIGNS
	TREES
	APPLICATION SITE BOUNDARY (AREA INCLUDES FOR EARTHWORK BATTERS AND TREES)

REVISIONS FOLLOWING PLANNING / HIGHWAY COMMENTS AS ANNOTATED	AMRP	18.11.09.	PL3
REVISIONS FOLLOWING PLANNING / HIGHWAY COMMENTS	AMRP	29.10.09.	PL2
PLANNING APPLICATION ISSUE	AMRP	20.03.09.	PL1
Revision Details	By	Date	Suffix
	TMN		
	Check		

PLANNING APPLICATION

06_4074_SK37 PL3

Scale at A3 : NTS

Drw	AMRP	App	TMN	Rev	
Chk	TMN	Date	20.03.09	Date	



www.scottwilson.com