



Client

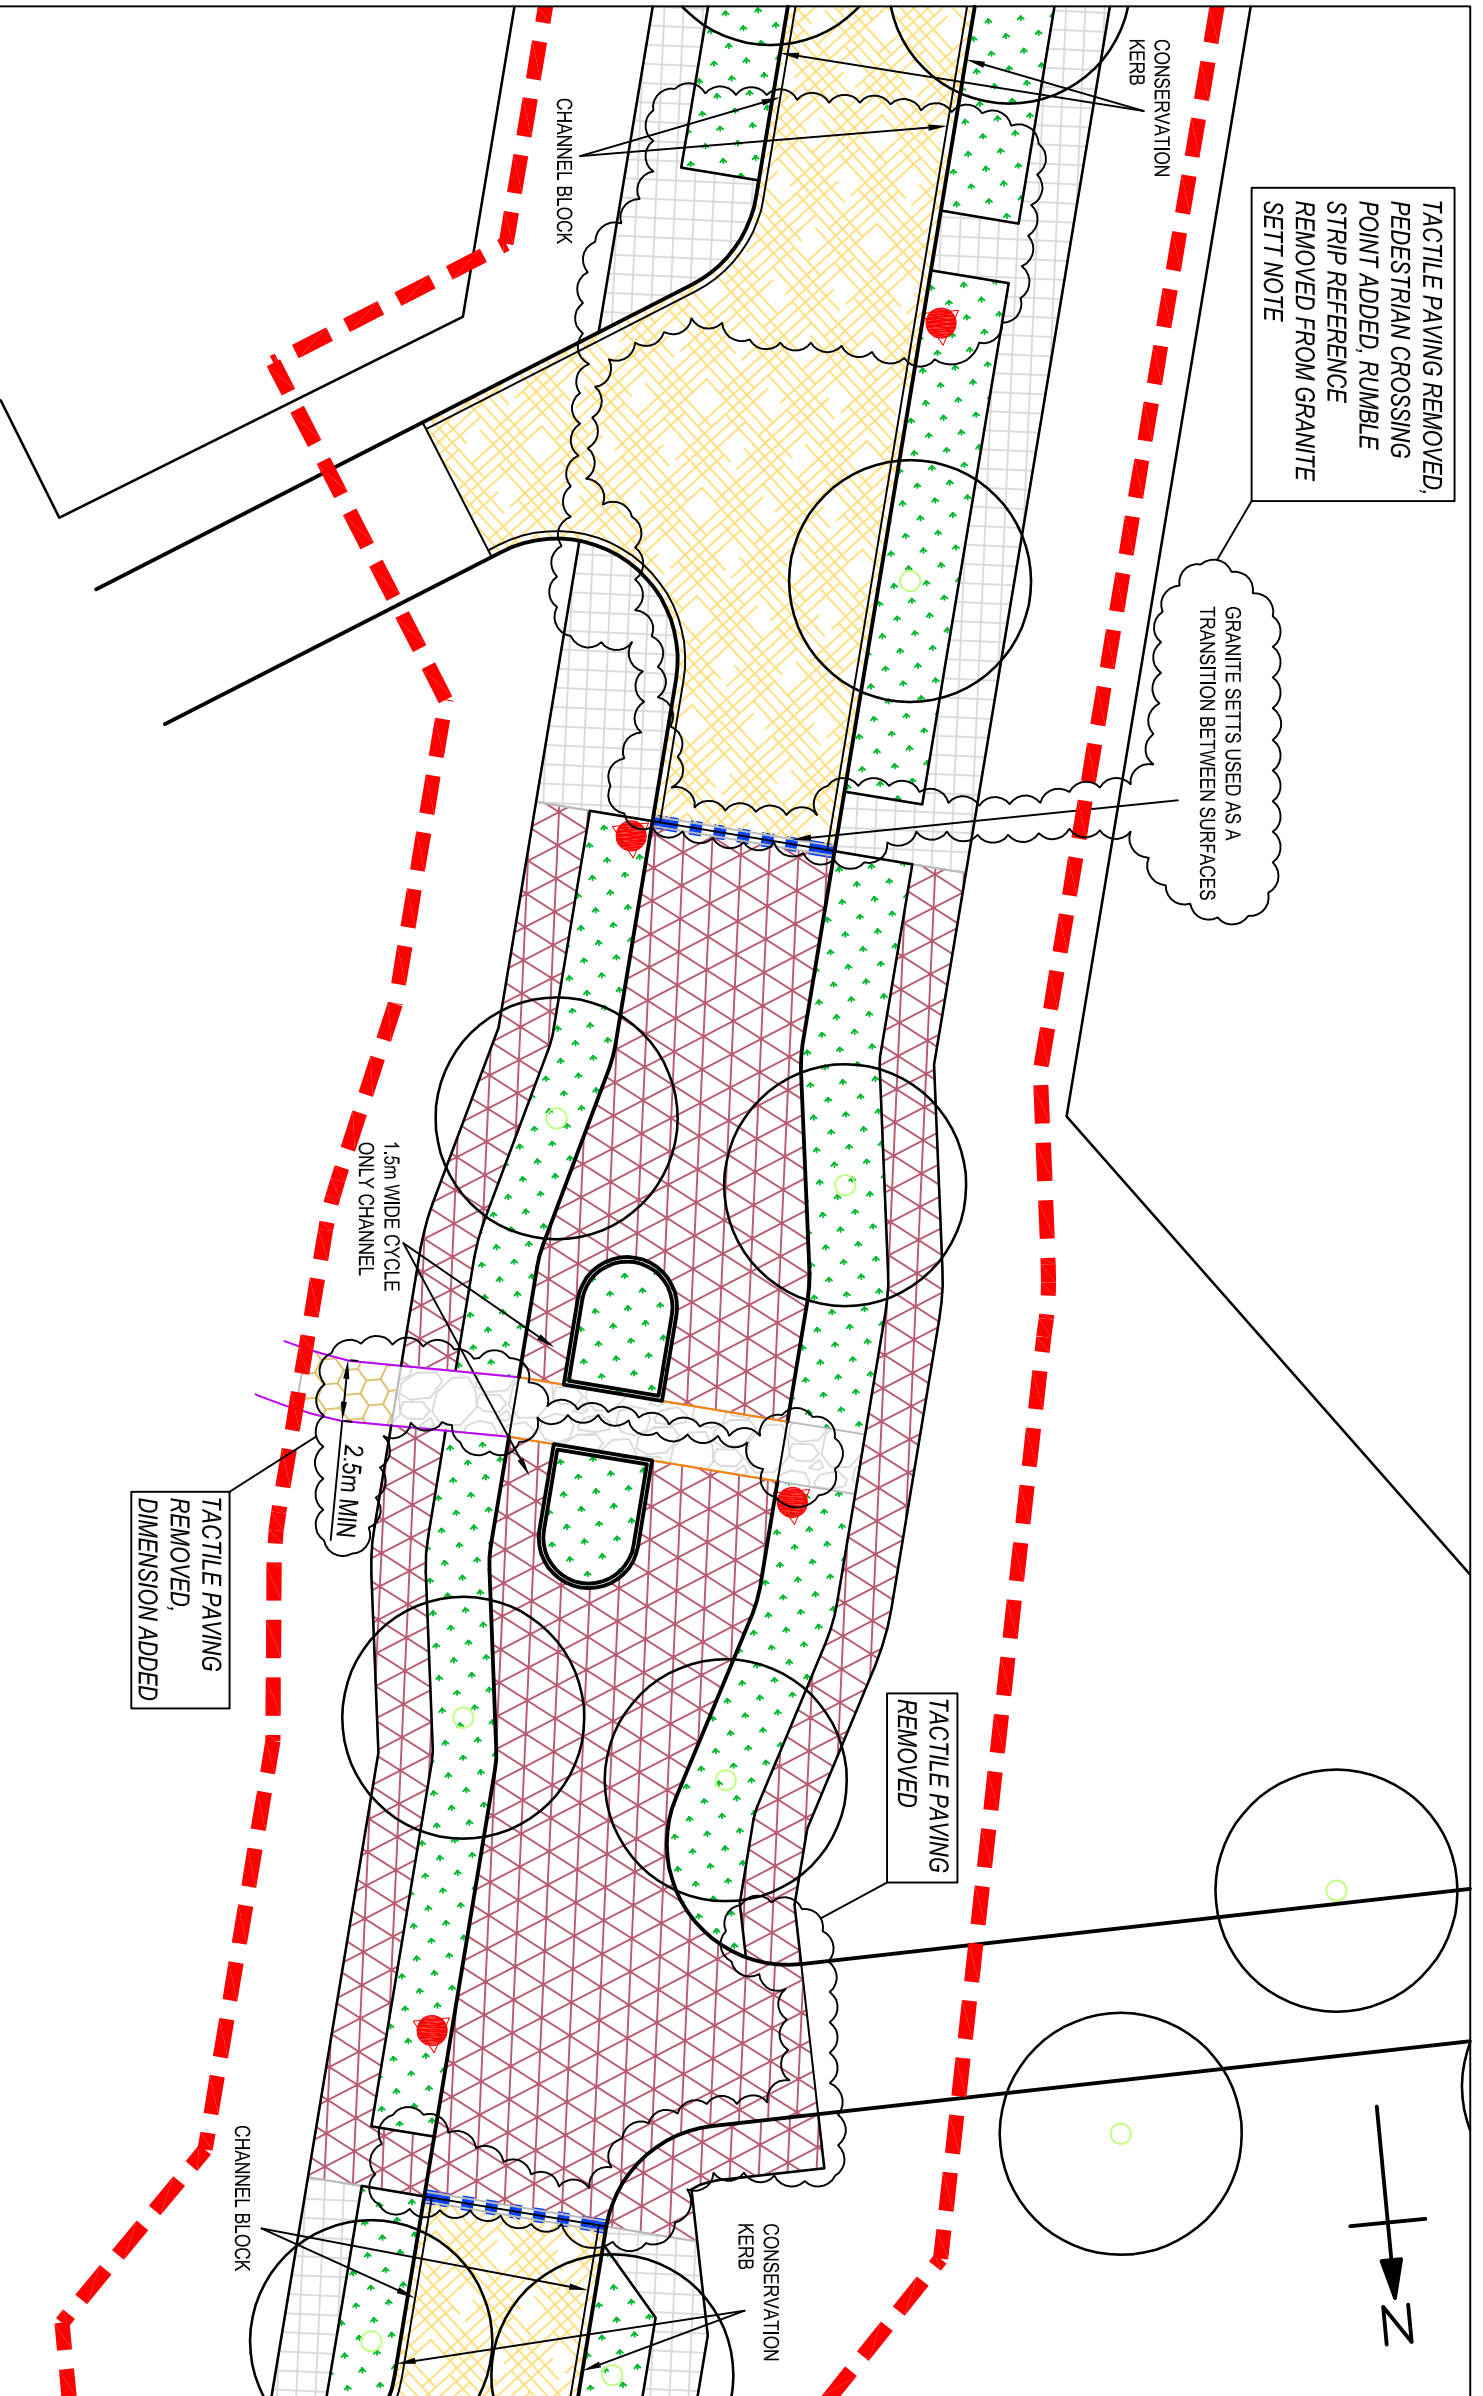

Drawing Title

**COUNTRYSIDE PROPERTIES
CLAY FARM, CAMBRIDGE
PRIMARY ROUTE SURFACE FINISHES
CHICANE 2 AT GREEN LINK**

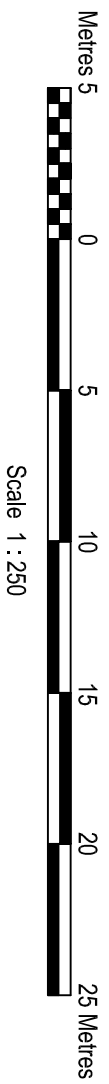

TACTILE PAVING REMOVED,
PEDESTRIAN CROSSING
POINT ADDED, RUMBLE
STRIP REFERENCE
REMOVED FROM GRANITE
SETT NOTE

GRANITE SETTS USED AS A
TRANSITION BETWEEN SURFACES

1.5m WIDE CYCLE
ONLY CHANNEL

2.5m MIN

TACTILE PAVING
REMOVED,
DIMENSION ADDED

TACTILE PAVING
REMOVED



- NOTES:
1. ALL DRAWN INFORMATION OUTSIDE RED LINE IS FOR INDICATIVE PURPOSES ONLY.
 2. FOR JUNCTION LOCATION SEE DRAWING NOS 06_4074_CL_100-CL_102
 3. FOR DIMENSIONS REFER TO DRAWING NOS 06_4074_CL_103-CL_105

KEY

- CARRIAGEWAY / FOOTWAY - KEYBLOK CHARCOAL
- ANTHRACITE BASALT BLOCK PAVING
- CYCLEWAY-DBM
- CYCLEWAY/FOOTWAY - COLOURED HRA
- FOOTWAY - DBM
- TEXT REVISED
- COMPACTED GRAVEL
- PLANTING
- CARRIAGEWAY / PARKING AREAS - HRA
- TACTILE SLABS
- 75mm RAMP TO RAISED TABLE - GRANITE SETTS
- 4 ROWS OF GRANITE SETTS
- STREET LIGHTS
- TRAFFIC LIGHTS
- ROADSIGNS
- TREES
- APPLICATION SITE BOUNDARY (AREA INCLUDES FOR EARTHWORK BATTERS AND TREES)

REVISIONS FOLLOWING PLANNING / HIGHWAY COMMENTS AS ANNOTATED	AMRP	18.11.09.	PL3
REVISIONS FOLLOWING PLANNING / HIGHWAY COMMENTS	AMRP	29.10.09.	PL2
PLANNING APPLICATION ISSUE	AMRP	20.03.09.	PL1

Revision Details	By	Date	Suffix
	TMN		
	Check		

PLANNING APPLICATION

06_4074_SK42 PL3

Scale at A3 : 1:250

Drw	AMRP	App	TMN	Rev
Chk	TMN	Date	20.03.09	Date



www.scottwilson.com