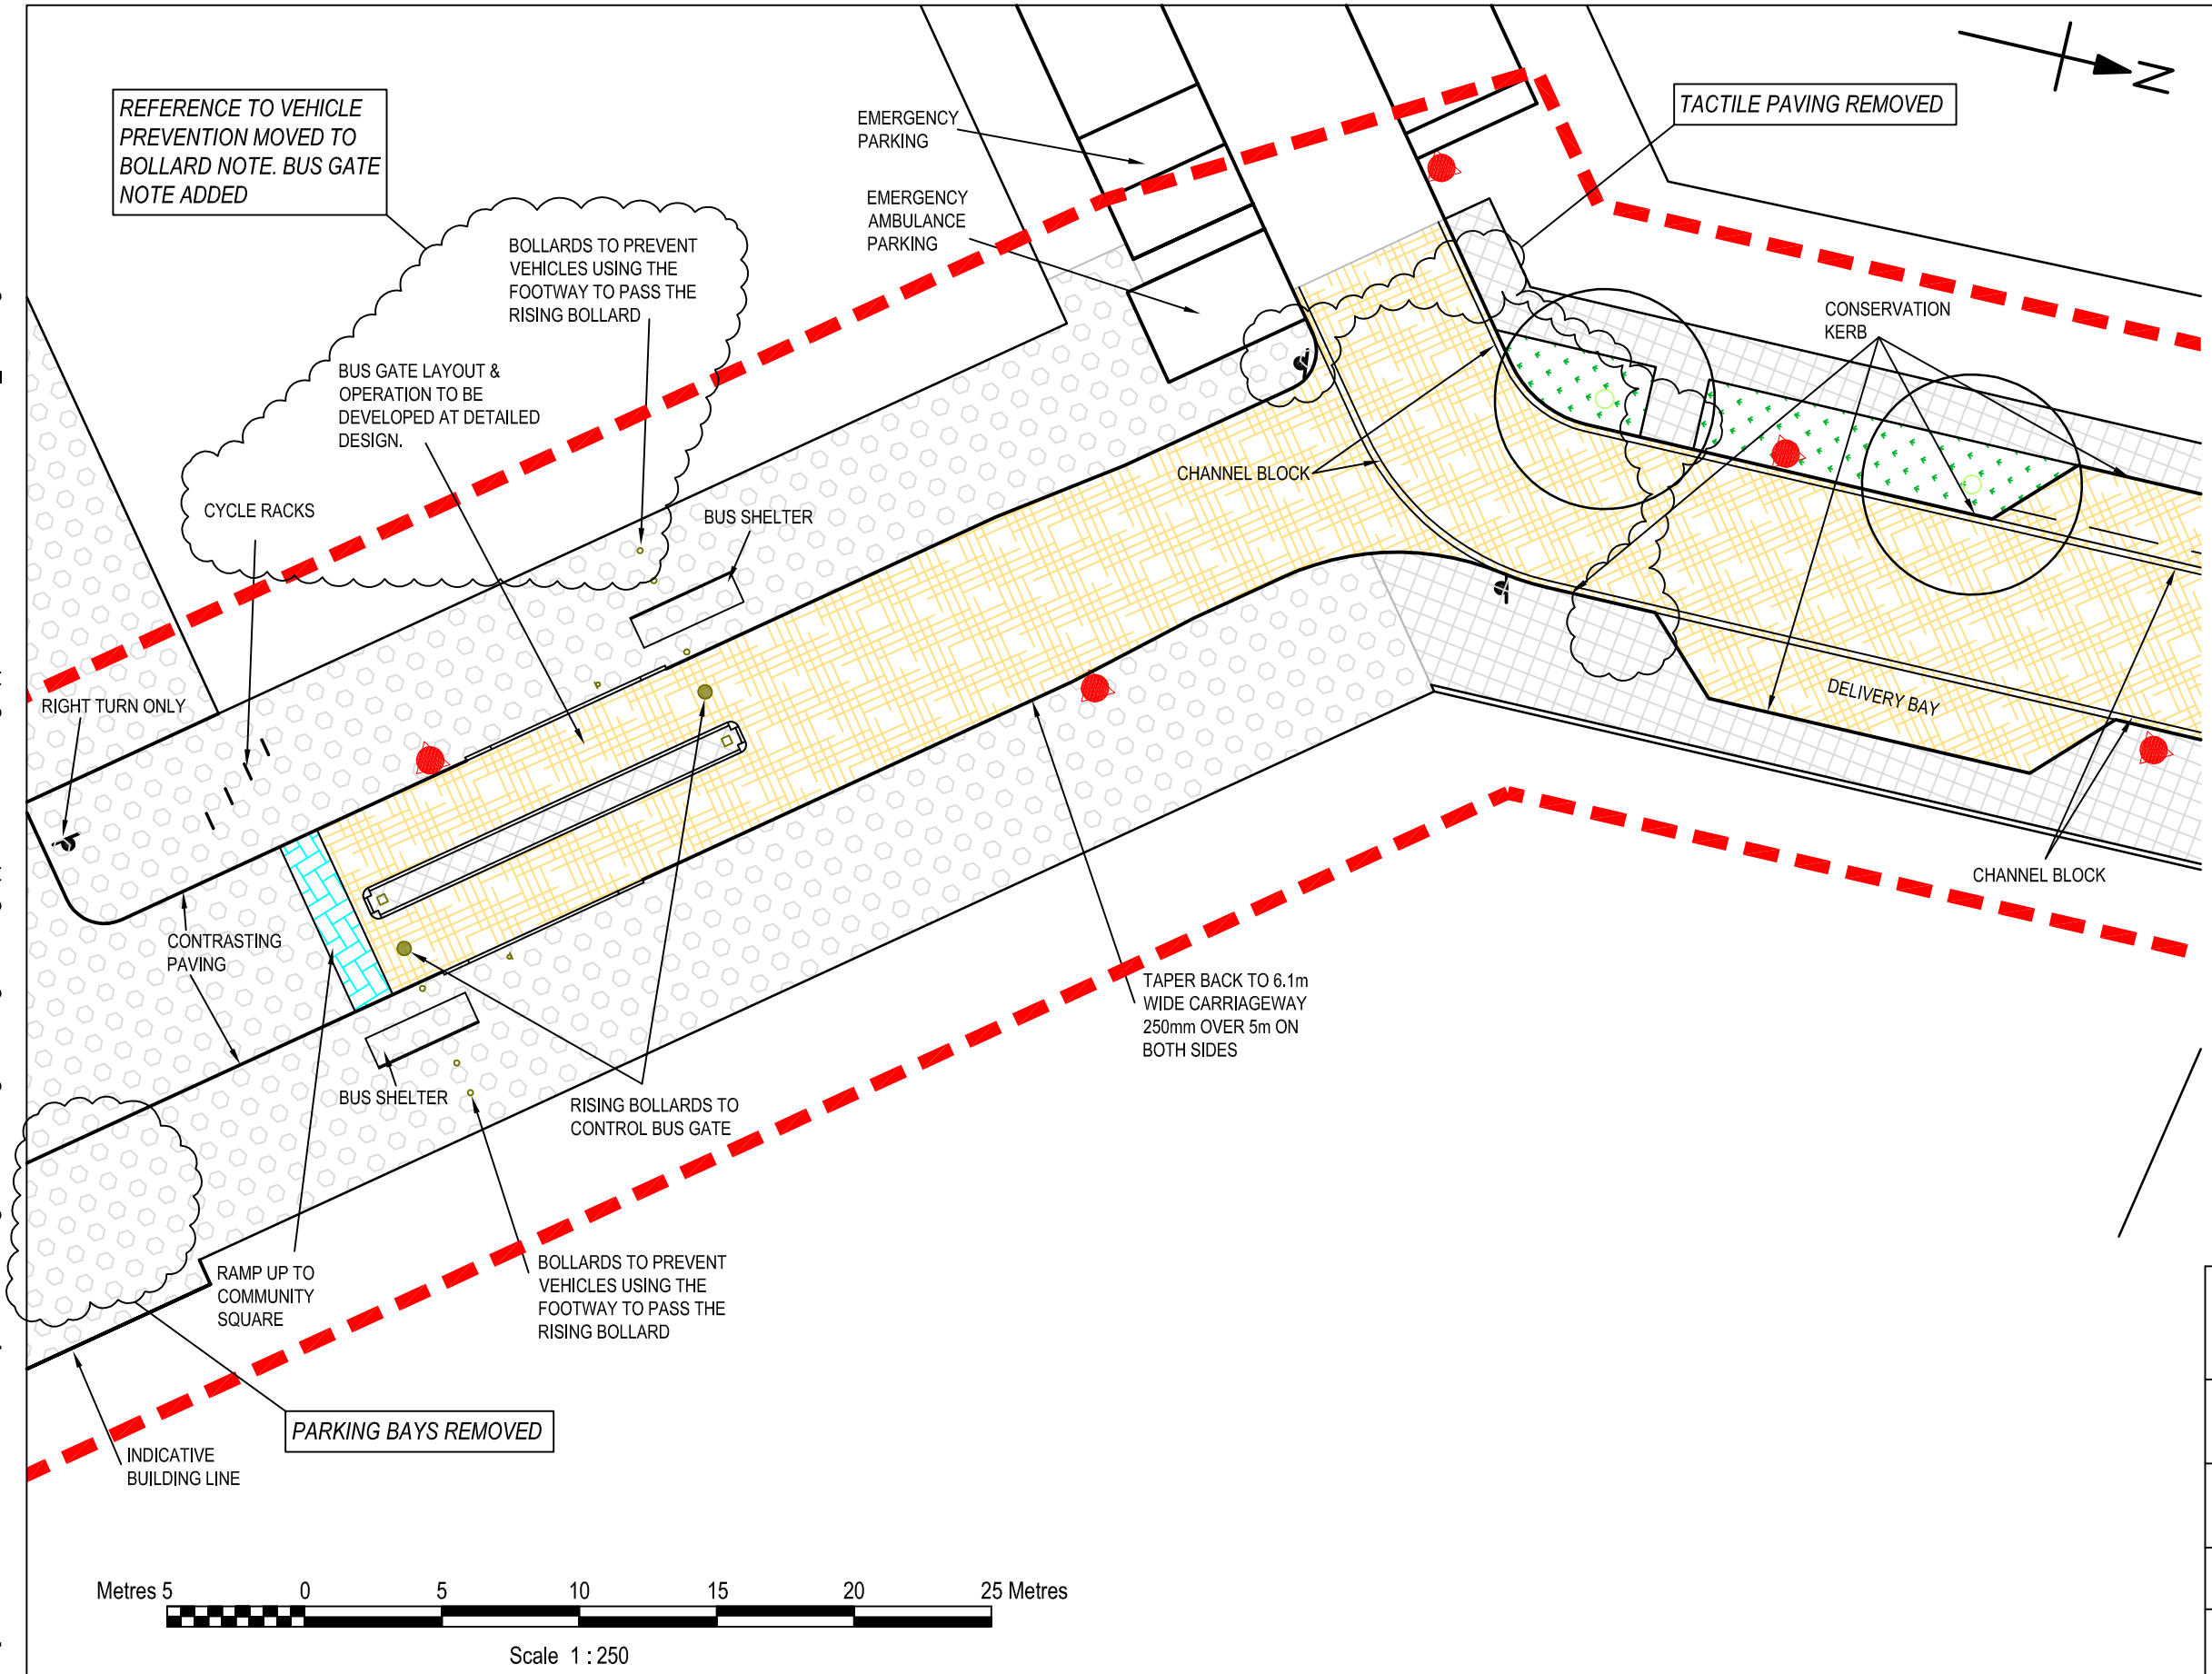

NOTES:

1. ALL DRAWN INFORMATION OUTSIDE RED LINE IS FOR INDICATIVE PURPOSES ONLY.
2. FOR JUNCTION LOCATION SEE DRAWING NOs 06_4074 CL_100-CL_102
3. FOR DIMENSIONS REFER TO DRAWING NOs 06_4074 CL_103-CL_105

KEY

- CARRIAGEWAY / FOOTWAY - KEYBLOK CHARCOAL
- ANTHRACITE BASALT BLOCK PAVING
- CYCLEWAY-DBM
- CYCLEWAY/FOOTWAY - COLOURED HRA
- FOOTWAY - DBM
- CYCLEWAY/FOOTWAY - COMPACTED GRAVEL
- PLANTING
- CARRIAGEWAY / PARKING AREAS - HRA
- TACTILE SLABS
- 75mm RAMP TO RAISED TABLE - GRANITE SETTS
- 4 ROWS OF GRANITE SETTS
- STREET LIGHTS
- TRAFFIC LIGHTS
- ROADSIGNS
- TREES
- APPLICATION SITE BOUNDARY (AREA INCLUDES FOR EARTHWORK BATTERS AND TREES)

TEXT REVISED

Revision Details	By / Check	Date	Suffix
REVISIONS FOLLOWING PLANNING / HIGHWAY COMMENTS AS ANNOTATED	AMRP / TMN	18.11.09.	PL3
REVISIONS FOLLOWING PLANNING / HIGHWAY COMMENTS	AMRP / TMN	29.10.09.	PL2
PLANNING APPLICATION ISSUE	AMRP / TMN	20.03.09.	PL1

Status
PLANNING APPLICATION

Client
Countryside Properties

Drawing Title
COUNTRYSIDE PROPERTIES
CLAY FARM, CAMBRIDGE
PRIMARY ROUTE SURFACE FINISHES
BUS GATE AND LOADING BAY

06_4074_SK39 PL3

Scale at A3 : 1:250

Drw AMRP	App TMN	Rev
Chk TMN	Date 20.03.09	Date

Scott Wilson
www.scottwilson.com

Plot Date : NOVEMBER 2009
AutoCAD File Name : [CF] P:\Basildon Jobs\D125403 Clay Farm\6 Design\6.1 Drawings\Working\Planning application\Planning Application 20091109\SK35-SK46_PL3.dwg

DB3